
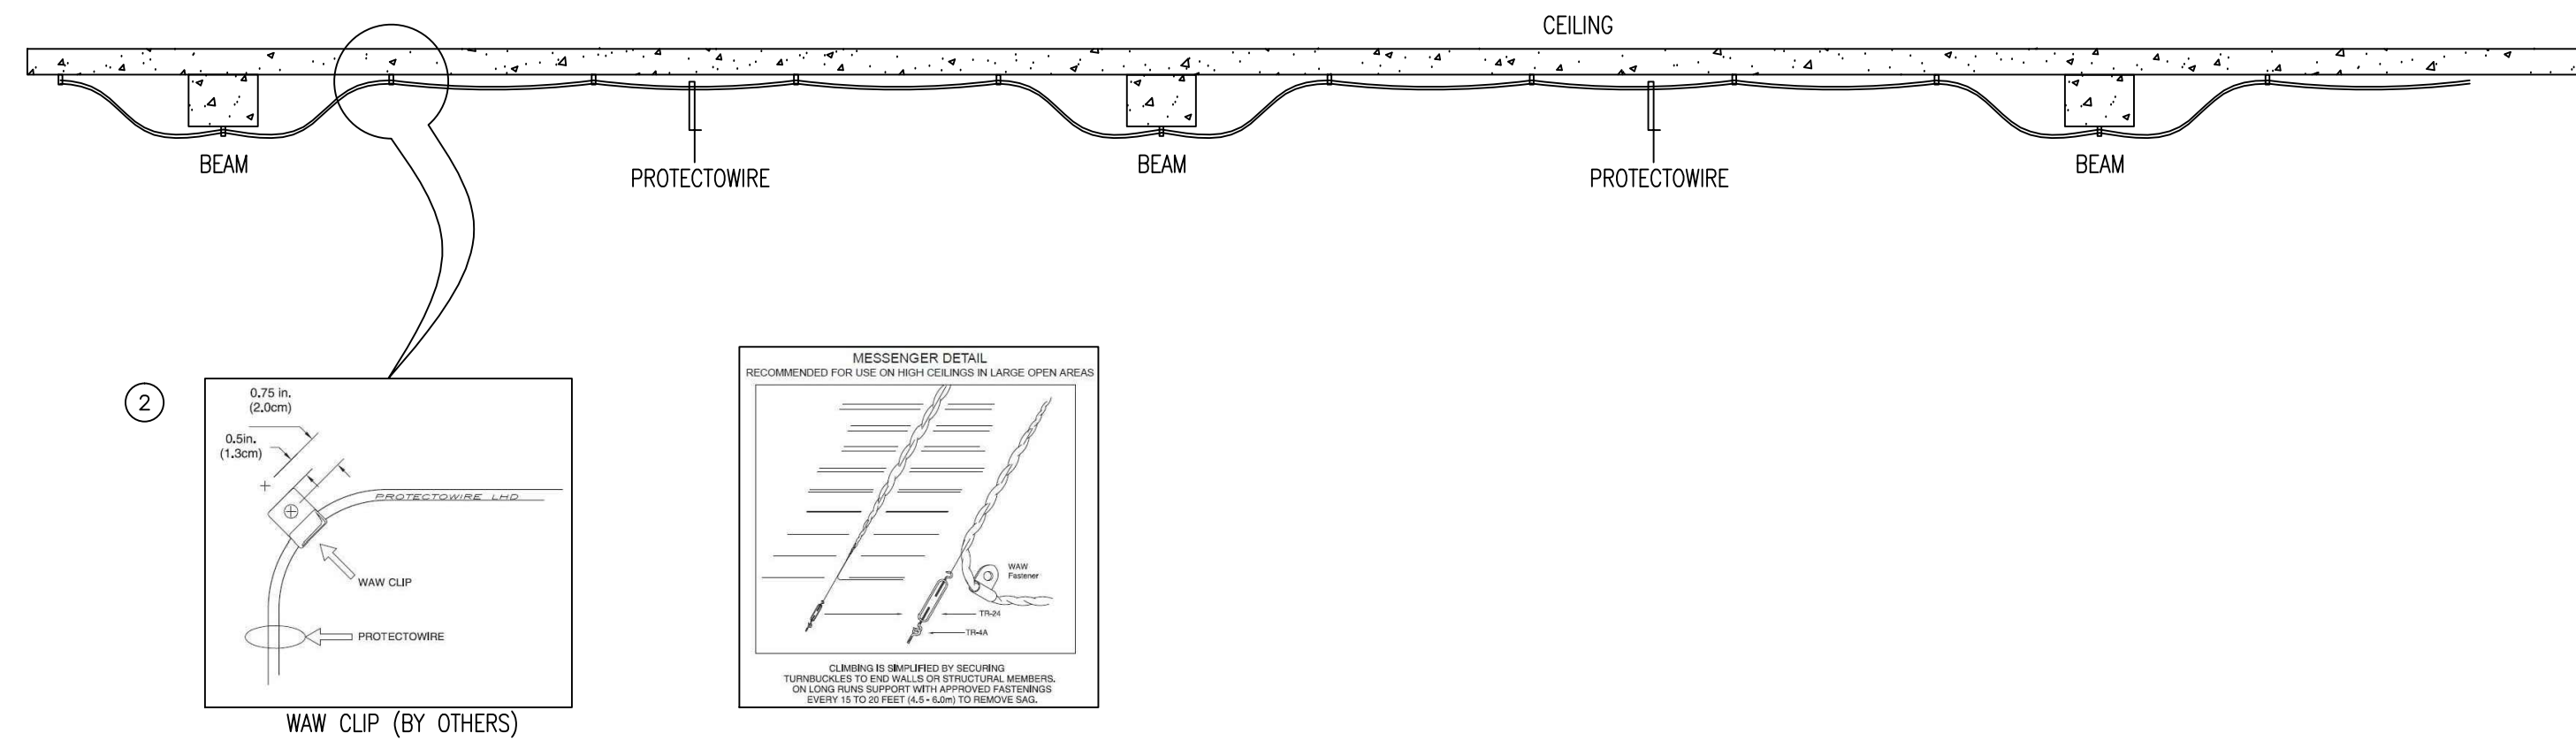


TYPICAL WIRING OF FIELD DEVICES

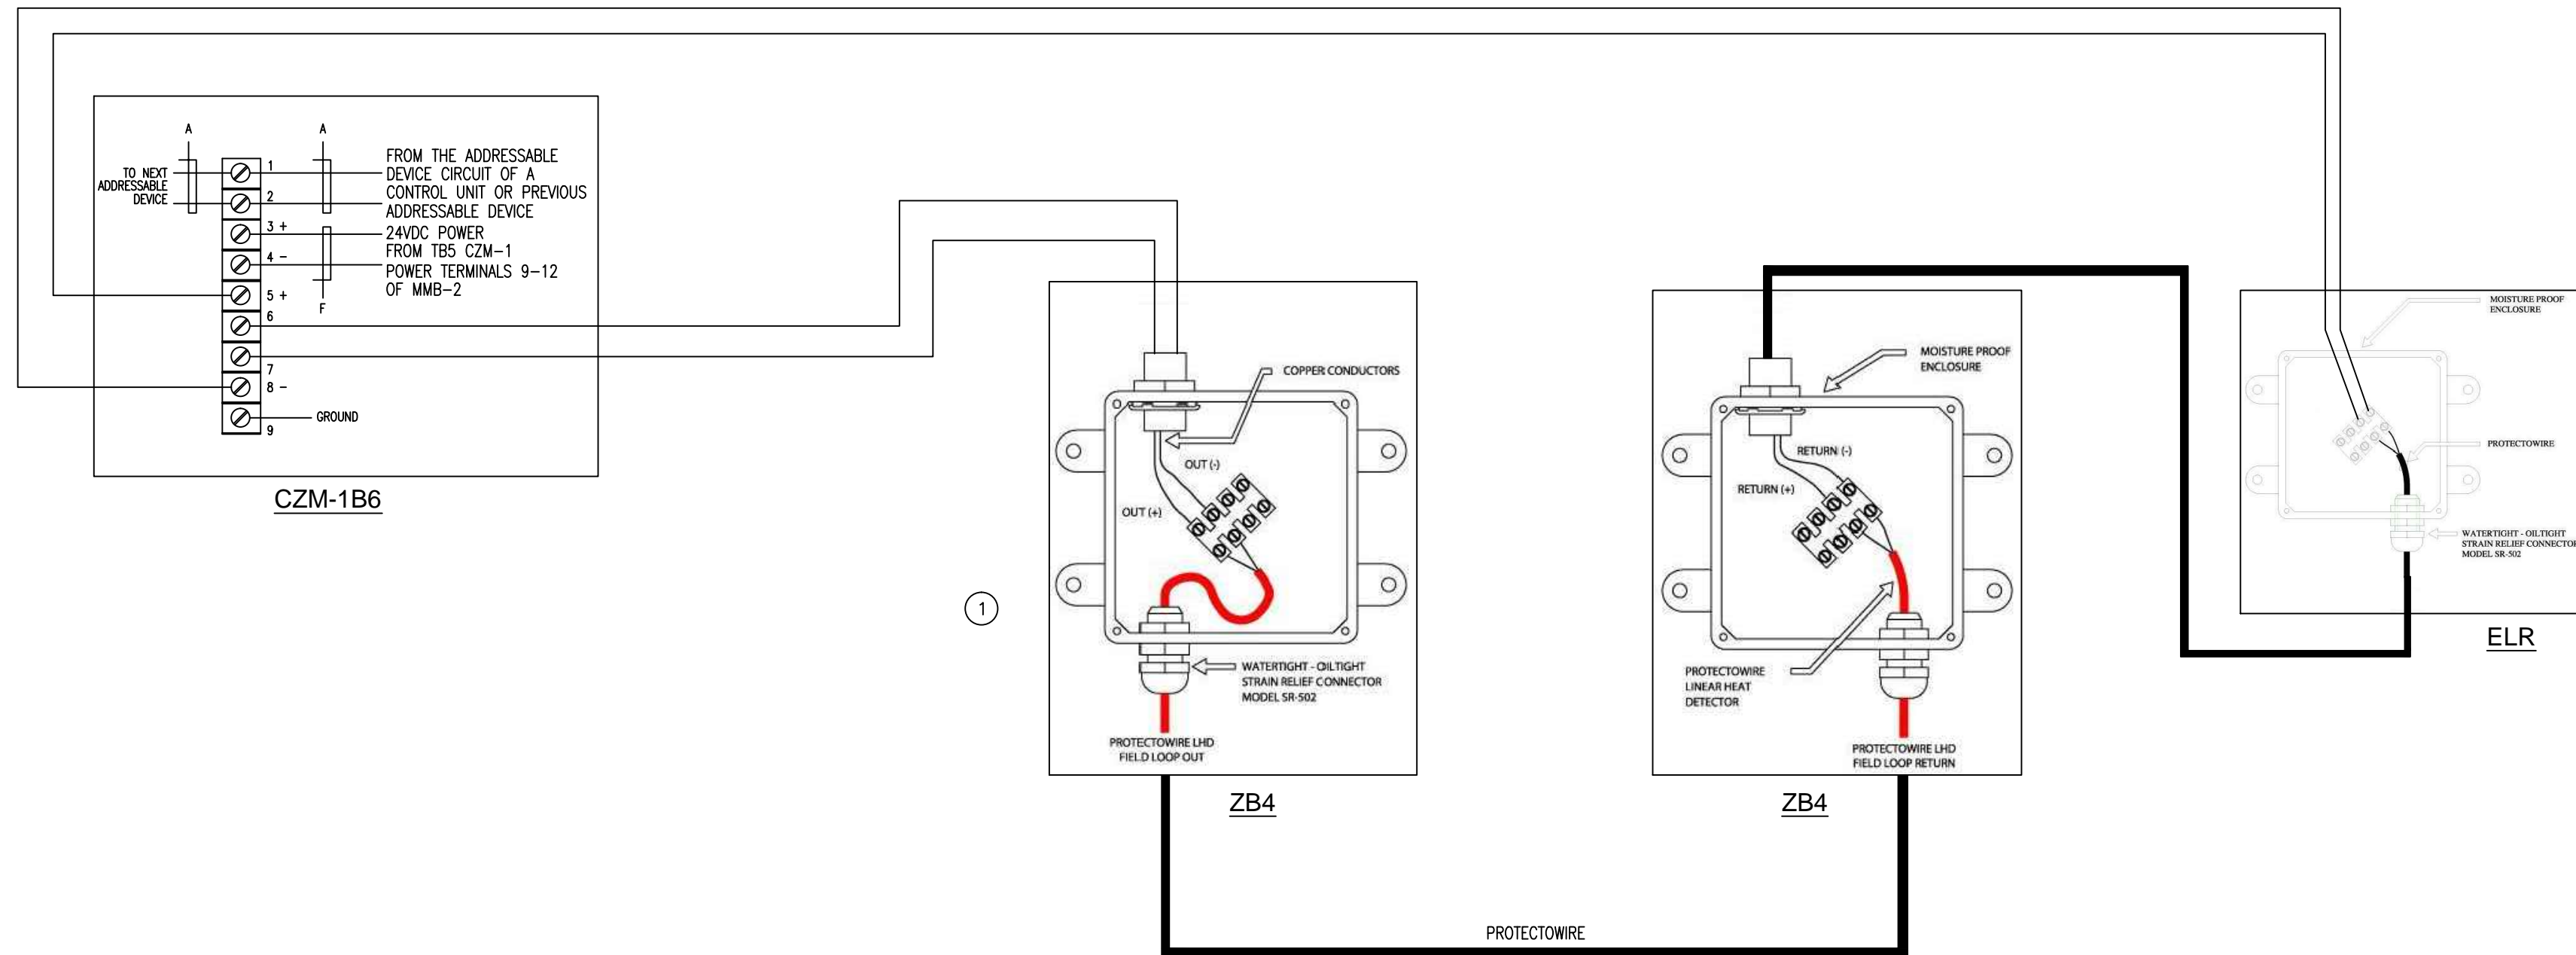

SHEET NOTES:

- ALL FIRE ALARM EQUIPMENT AND PROTECTOWIRE ZONE BOXES SHALL BE PLACED IN A LOCATION SUCH THAT THEY ARE READILY ACCESSIBLE FOR MAINTENANCE AND TESTING. (TYPICAL TO ALL OPEN CEILING AREAS)
- FASTENERS SHOULD TYPICALLY BE SPACED EVERY 5-10 FEET, OR AS MAY BE NECESSARY TO PREVENT THE WIRE FROM SAGGING WHICH PUTS UNDUE STRESS ON THE WIRE AT THE FASTENING POINTS.

THE DRAWINGS AND DESIGN HEREIN SHALL NOT BE REPRODUCED, COPIED OR INCORPORATED INTO OTHERS FOR REPRODUCTION OR OTHER PURPOSES WITHOUT THE WRITTEN PERMISSION OF THE DESIGNER. THE DESIGNER SHALL BE RESPONSIBLE FOR THE DESIGN OF THE PROJECT. THE DESIGNER SHALL BE RESPONSIBLE FOR THE DESIGN OF THE PROJECT.

REVISIONS

No.	Revision	By	Date	Appr.
1	RESPONSE TO HYT BULLETIN 5 REVIEW COMMENTS	JPM	10/19/10	KW
2	REVISED PER LBNL FIRE MARSHALS' COMMENTS	JPM	10/25/10	KW
3	AS-BUILT	JPM	9/20/12	KW

AS-BUILT

—10 APPROVAL STAMP

NUMBER OF CONTRACT DOCUMENTS



HYT Corporation
Fire Protection Engineers and Consultants
3498 Clayton Road - Suite 101 Concord, California 94519
Phone: (925) 681-2731 FAX: (925) 681-2733

INSTALLATION CONTRACTORS NAME & ADDRESS:

W. BRADLEY ELECTRIC, INC.

90 Hill Road,
Novato, CA 94945

Tel (415) 898-1400 Fax (415) 898-5991

PRODUCT MANUFACTURER:

Siemens Industry, Inc.
Fire Safety Division

25821 Industrial Boulevard, Suite 300
Hayward, California 94545-2991
Tel (510) 783-6000 Fax (510) 293-2100
California State C10 License No. 758796
U.L. Certificate ID No. 324787-001

JOB NAME & LOCATION (STREET ADDRESS)

UNIVERSITY OF CALIFORNIA
LAWRENCE BERKELEY NATIONAL LABORATORY
FACILITIES DIVISION

**BUILDING 74
FIRE ALARM
LBNL SEISMIC
PHASE 2**

One Cyclotron Road,
Berkeley, California 94720

SHEET NUMBER

**TYPICAL WIRING
OF FIELD DEVICES**

INSTALLATION TYPE

- ☐ NEW INSTALLATION
☐ DESIGN/BUILD
☐ PER CONTRACT DOCUMENT
☐ EXISTING BASE JOB # N/A
☐ OTHERS _____

SYSTEM SALES REP: Kevin Waxman

PROPERTY MANAGER: Mark Millard

DRAWN BY: JPM

CHECKED BY: FA-06

NOTED: Not Applicable

DATE DRAWN

March 18, 2010

PLOT DATE

March 27, 2014

SHEET

FA-06A

JOB NUMBER

44OP-069681

DRAWING NO.: **6N74E328**